


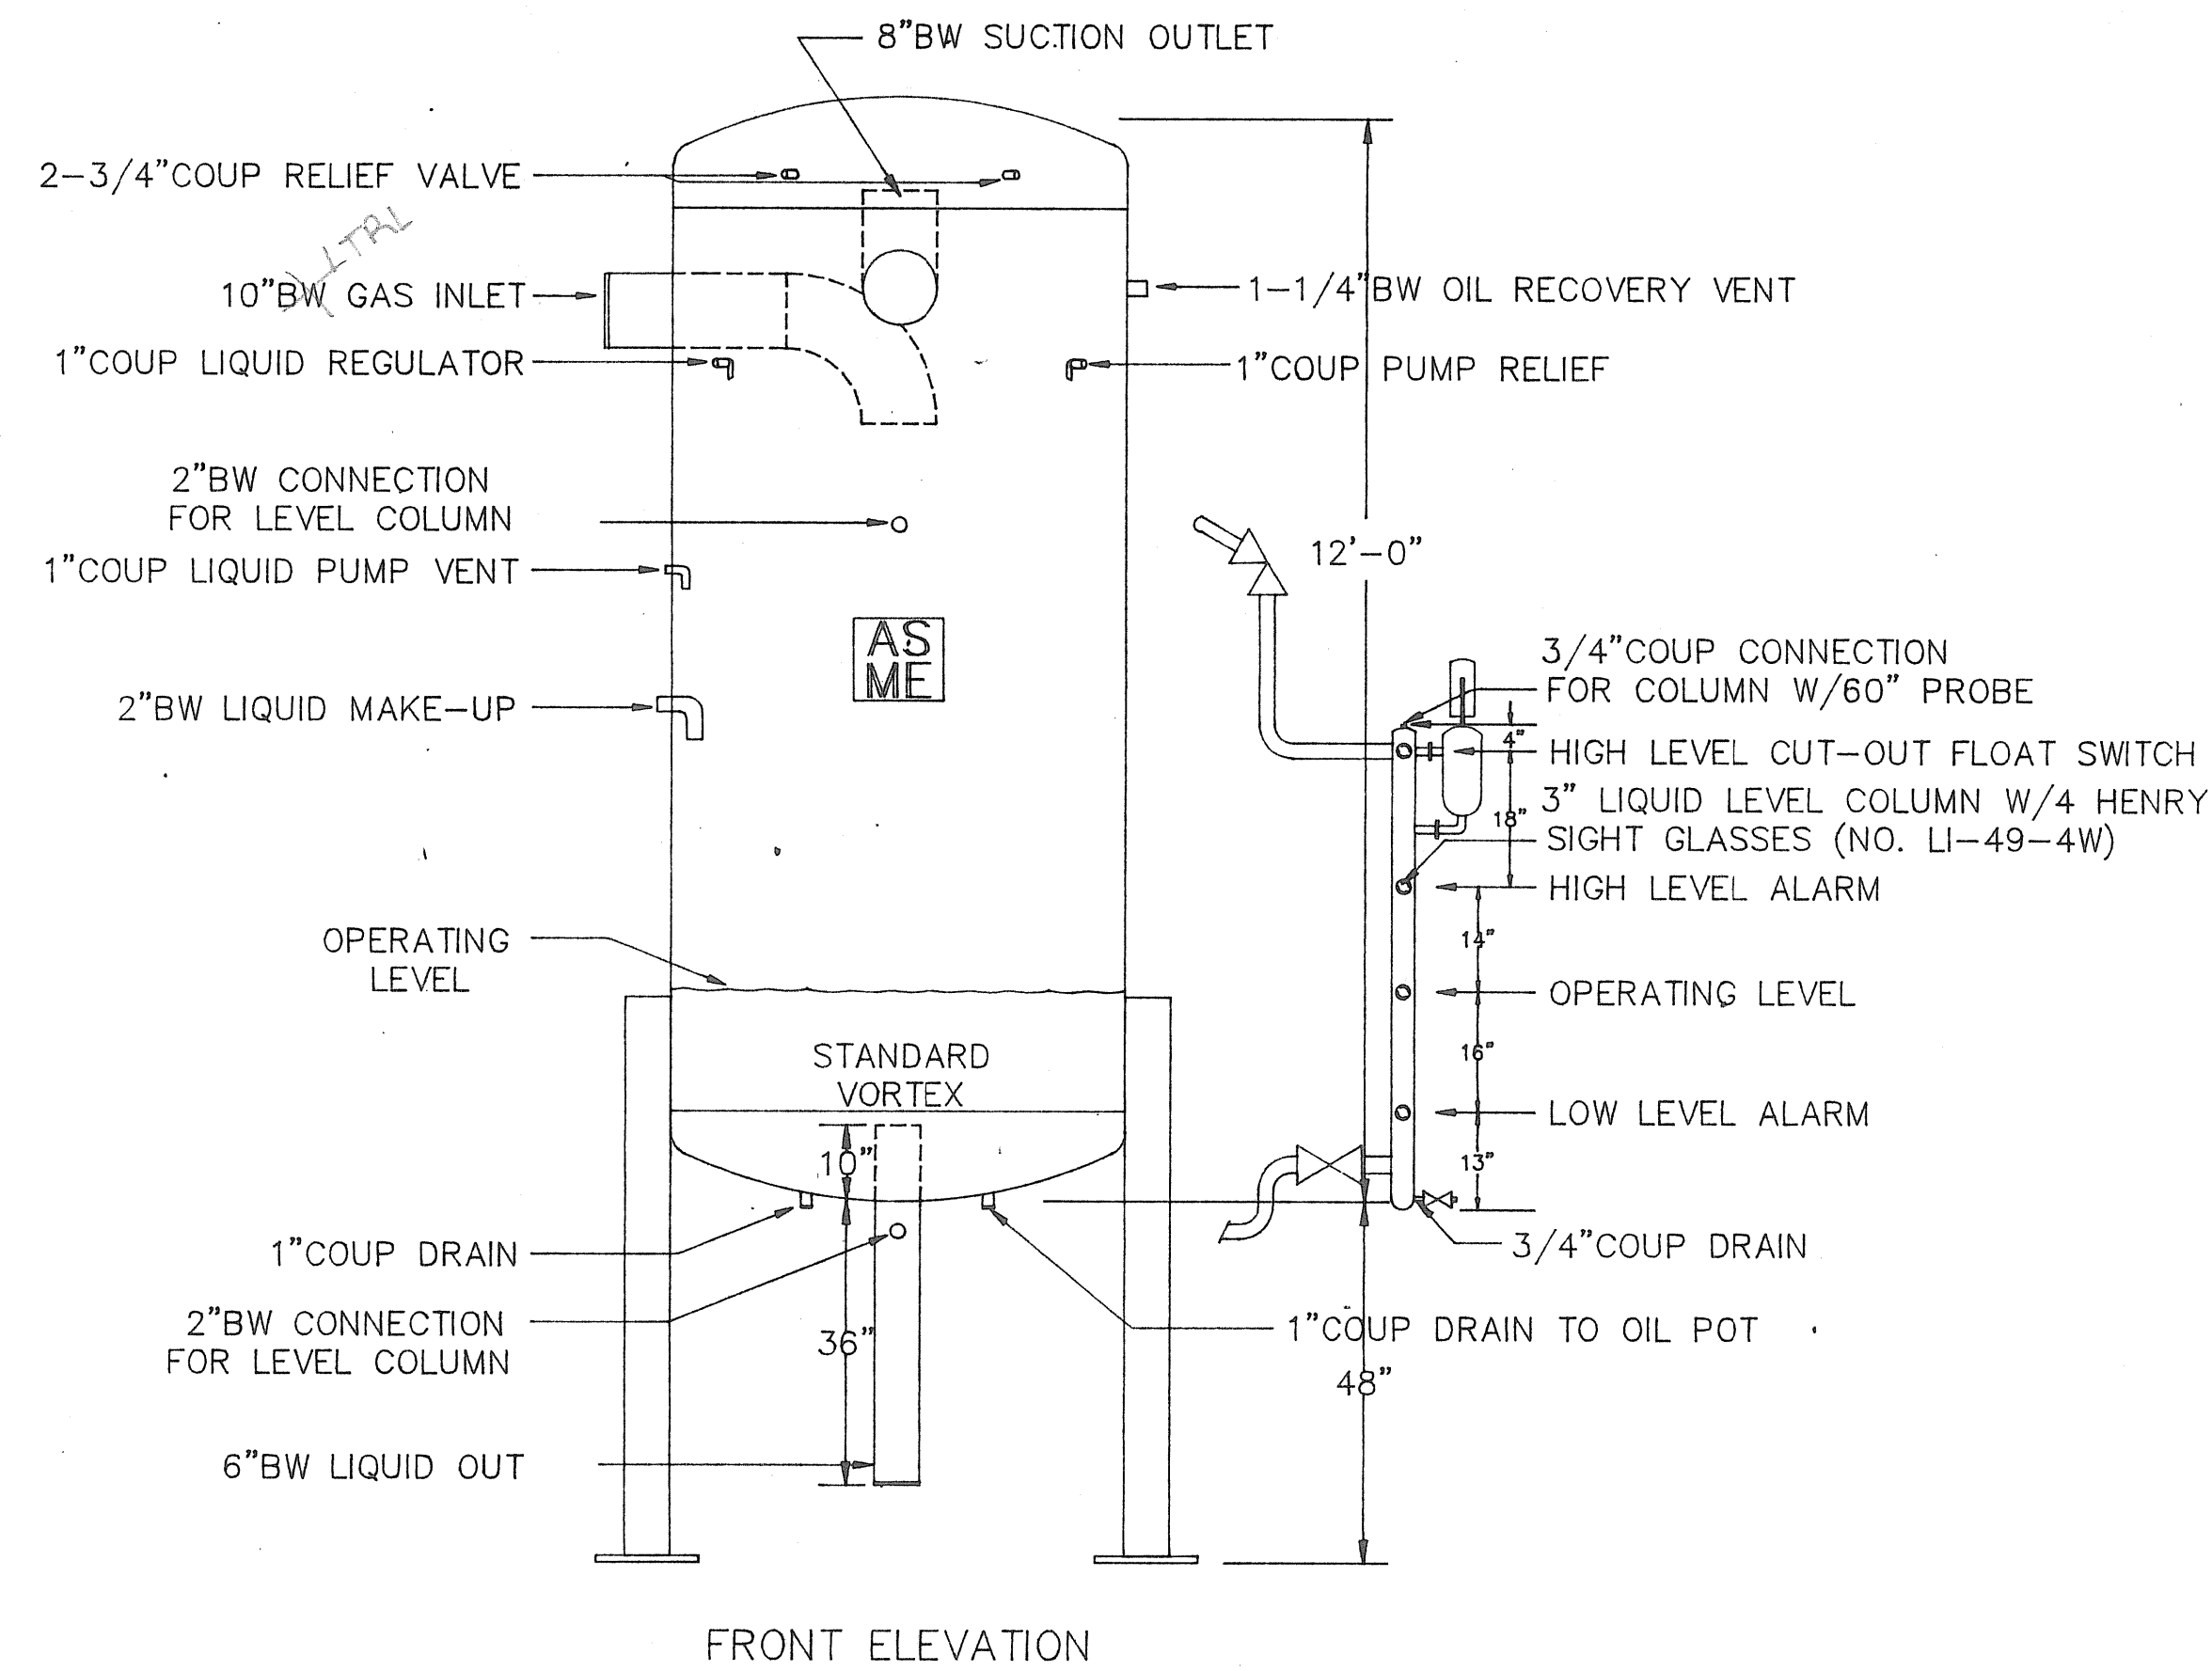


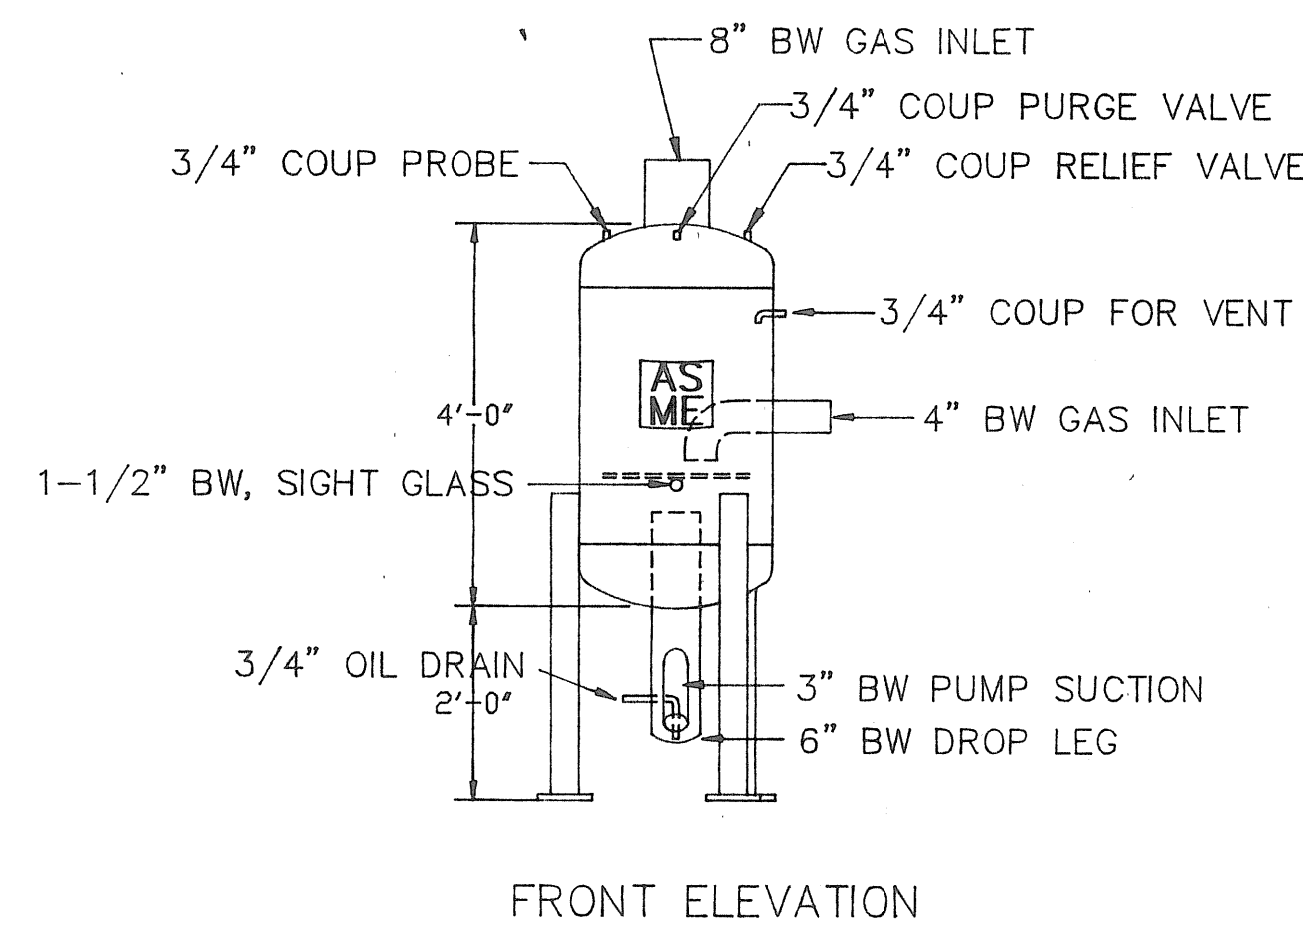


(-40) 60" O.D. X 12'-0" VERT 250# ASME
PUMP LIQUID RECIRCULATION VESSEL
SCALE: 1/2" = 1'-0"

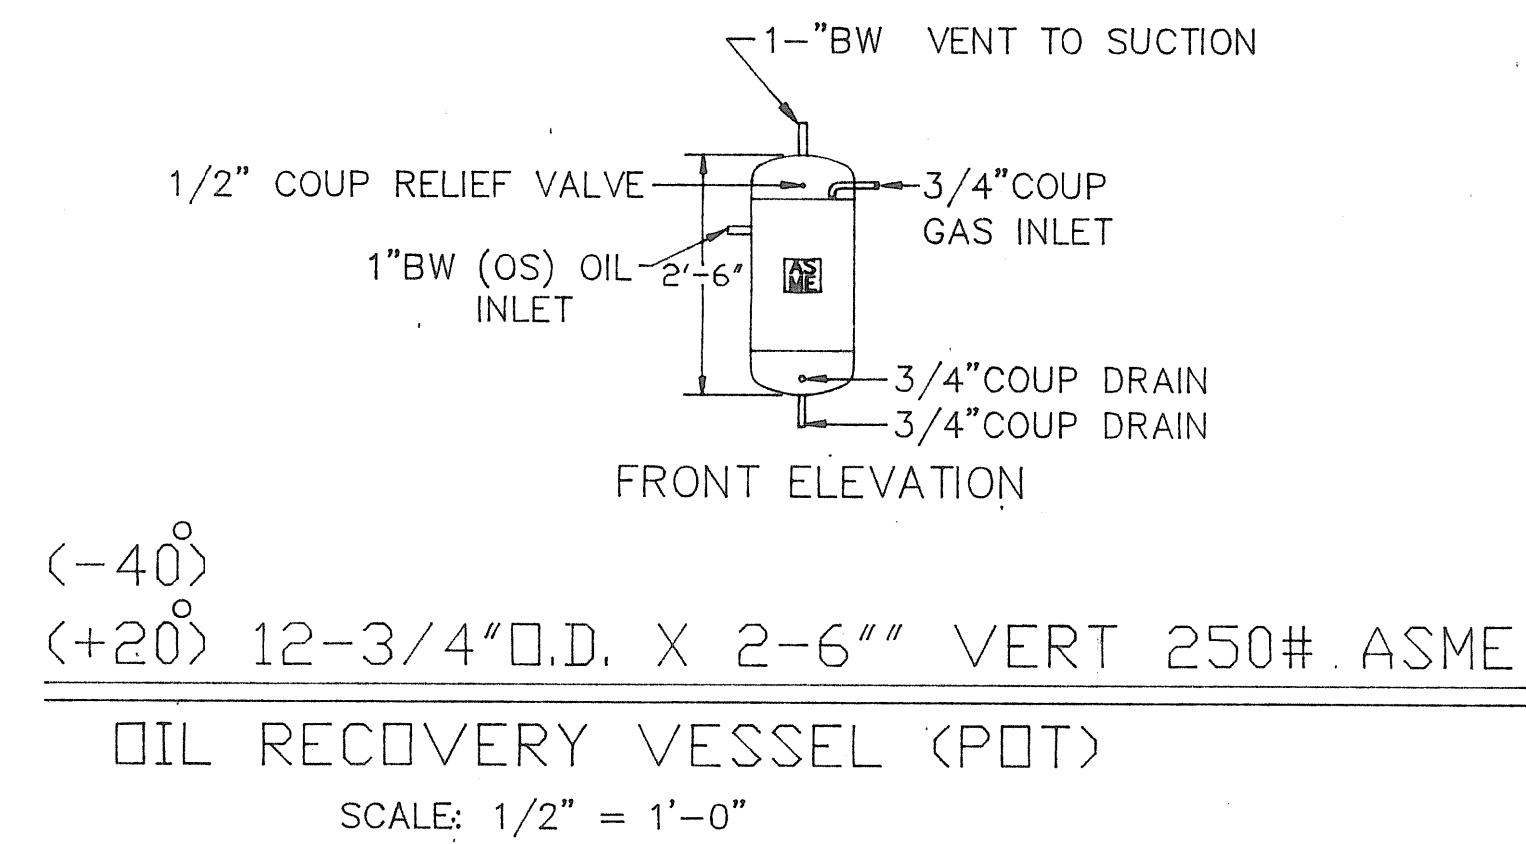


24" O.D. X 4'-0" VERT 150# ASME
TRANSFER VESSEL
SCALE: 1/2" = 1'-0"

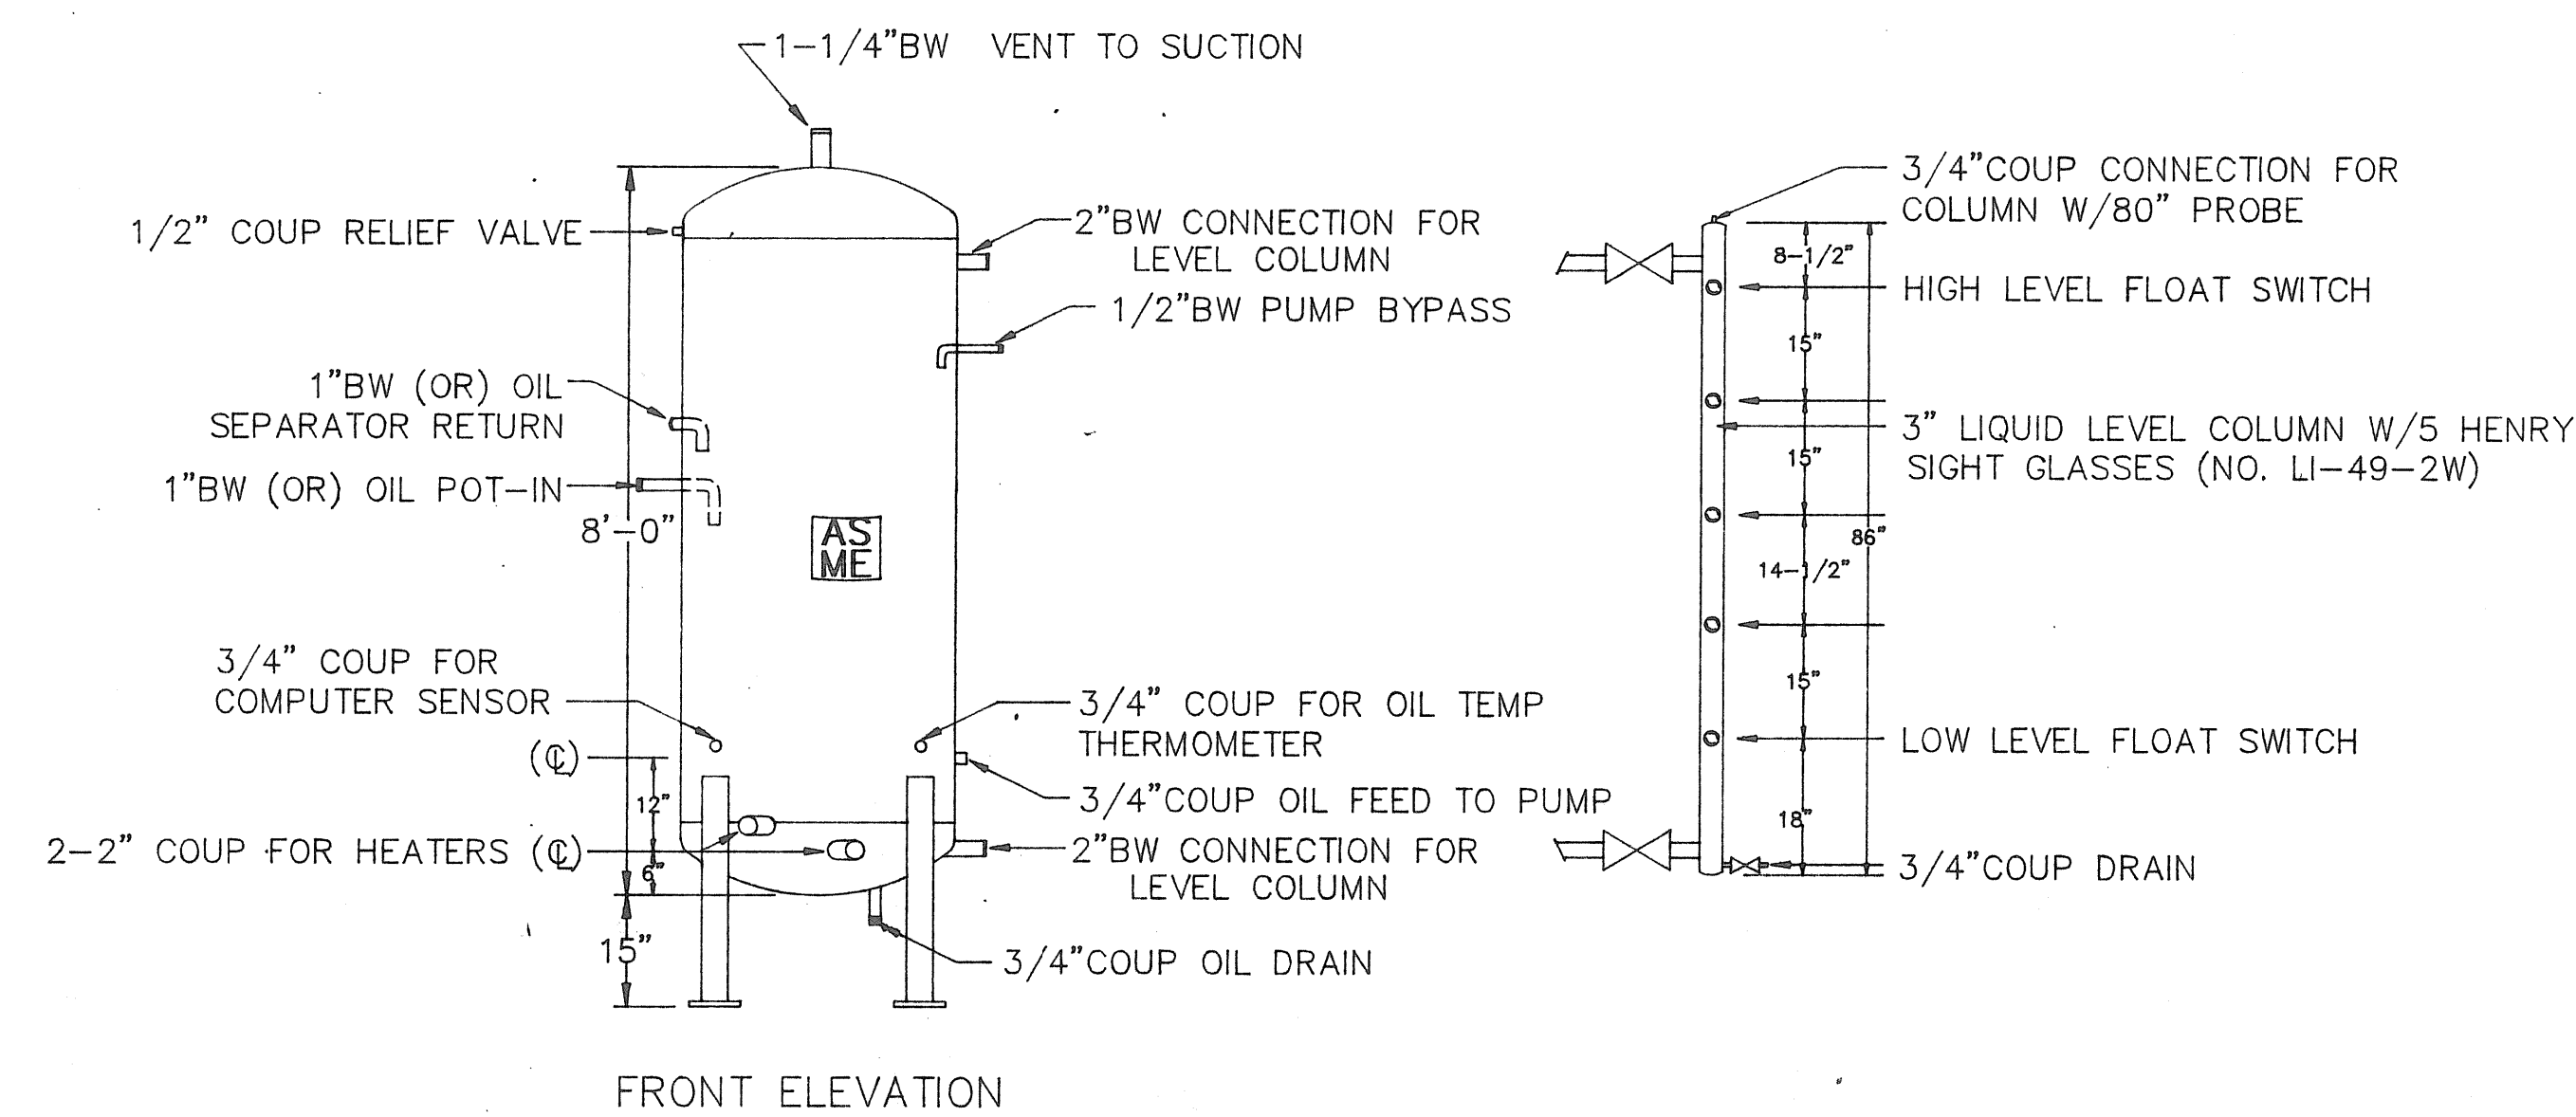

(+90) 36" O.D. X 8'-0" VERT 250# ASME
OIL RECOVERY RECEIVER VESSEL
SCALE: 1/2" = 1'-0"

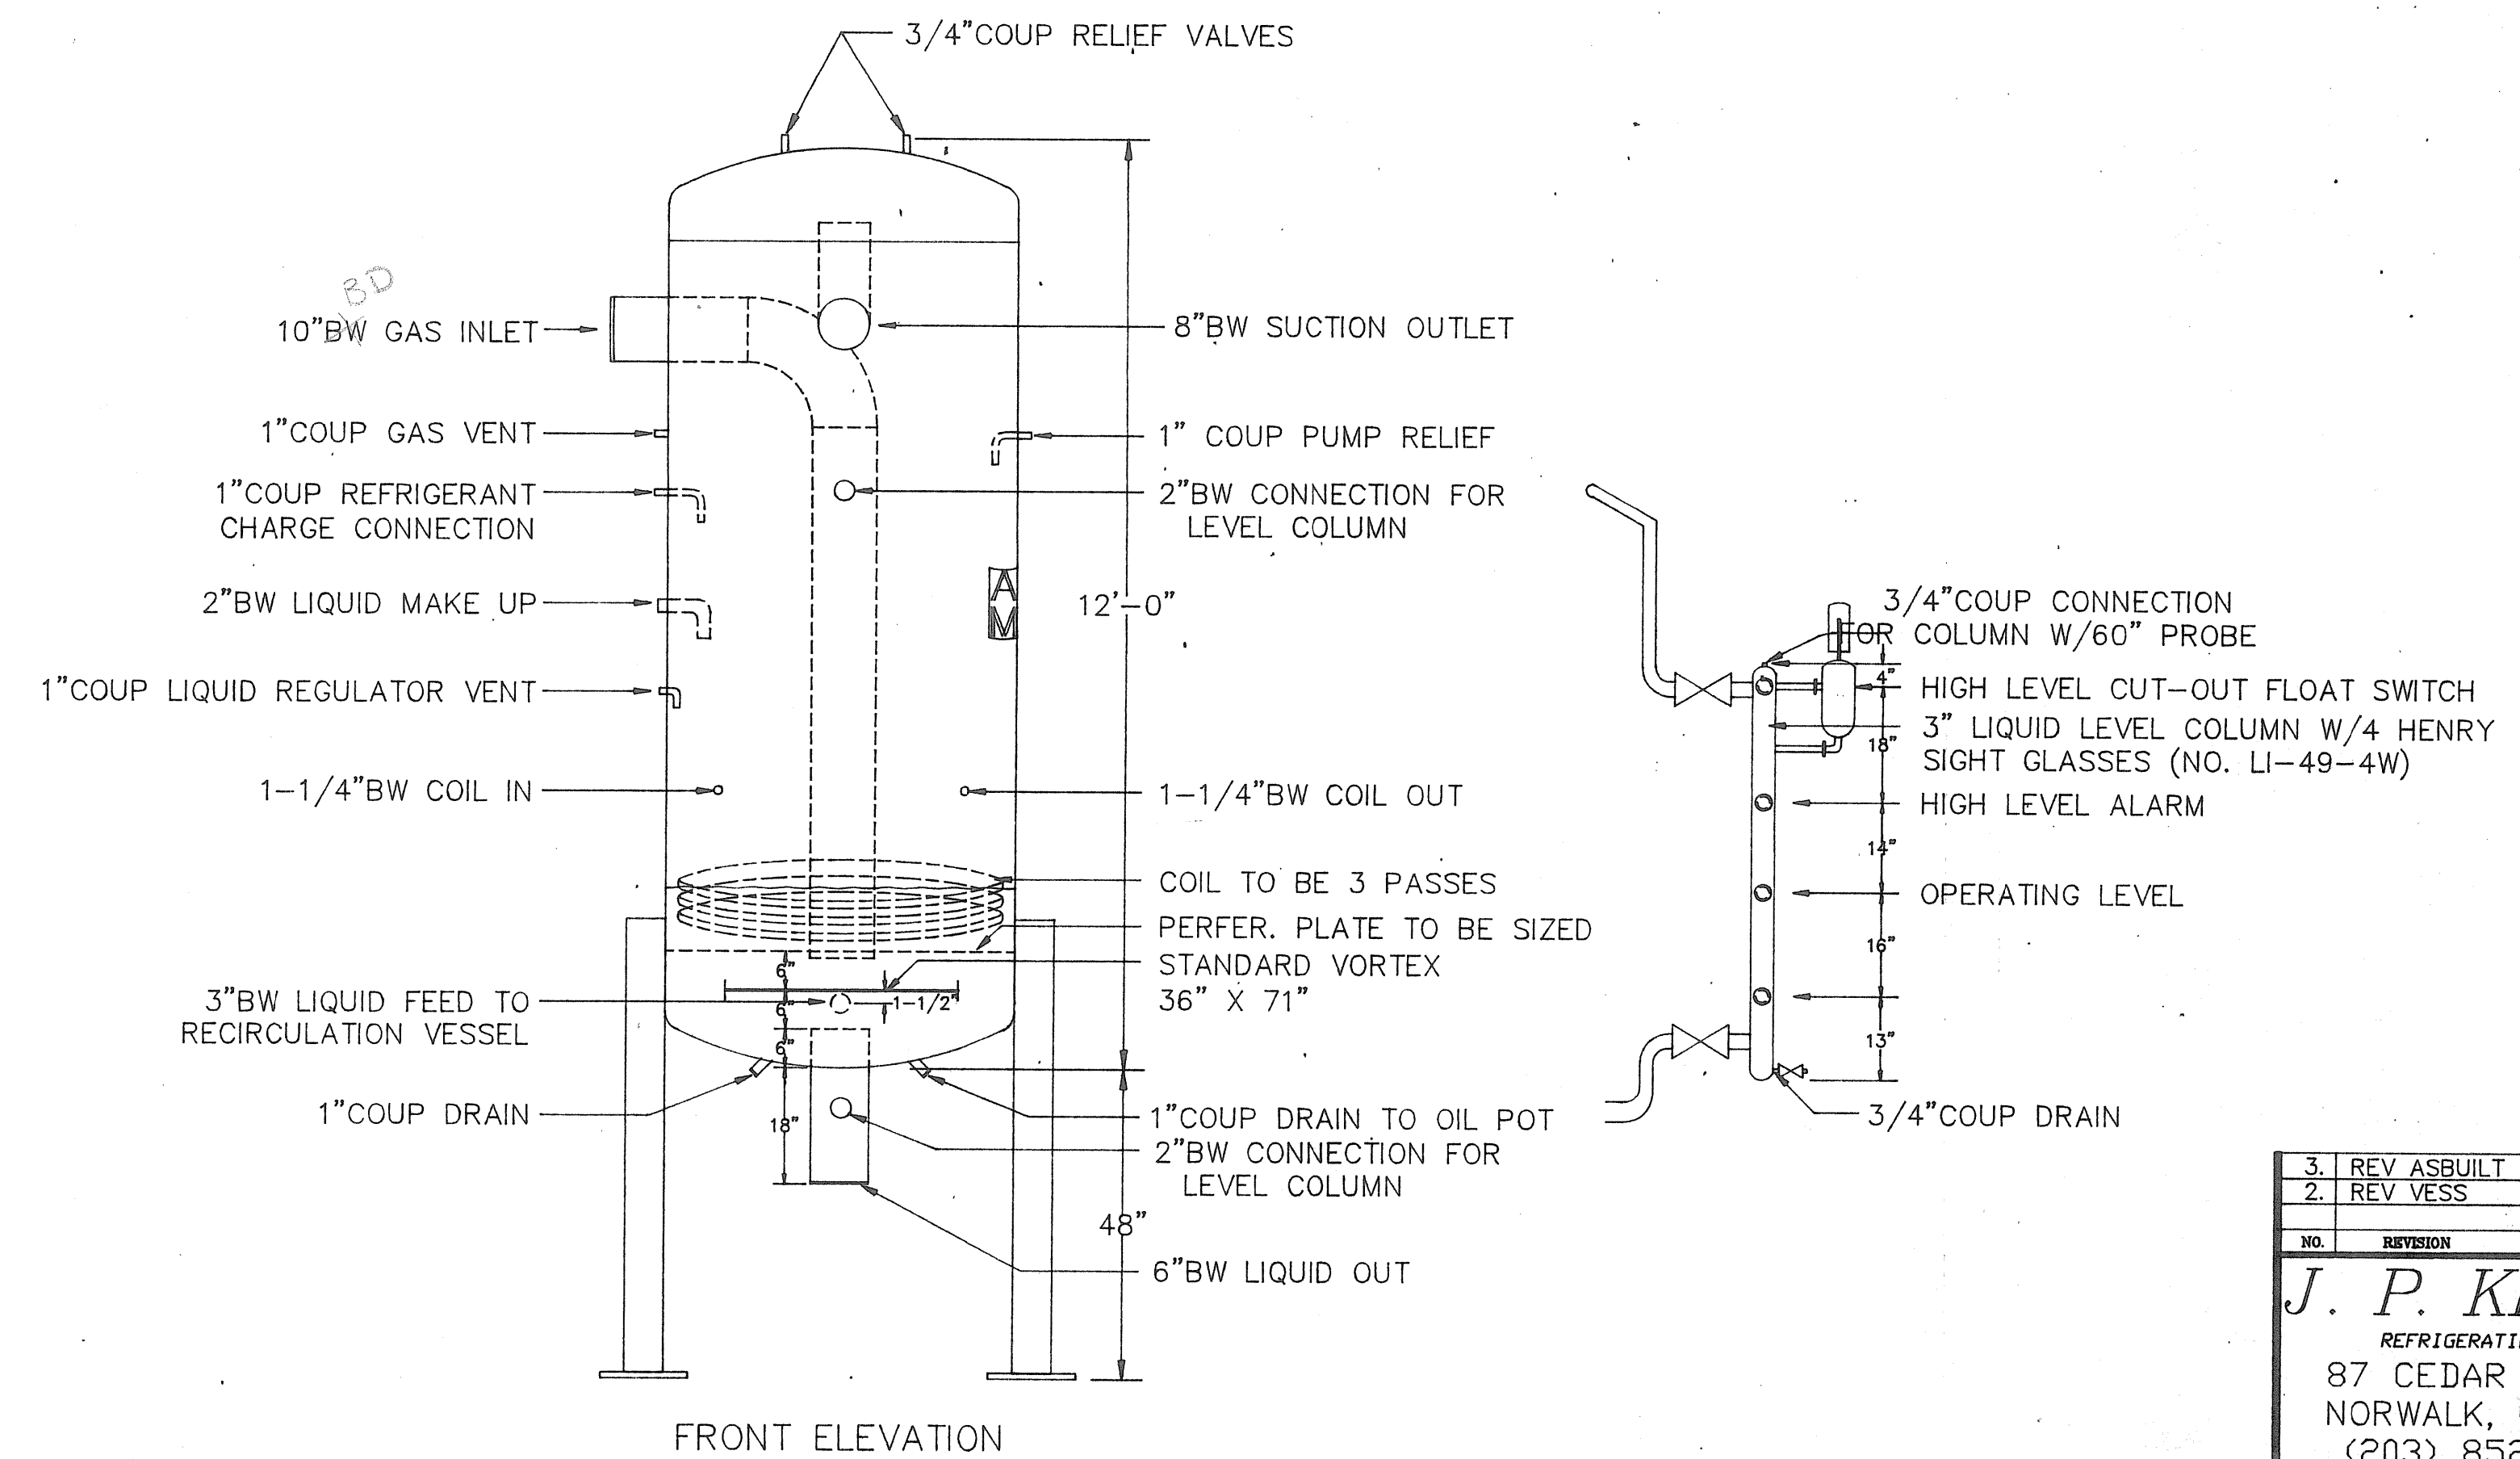

(+20) 54" O.D. X 12'-0" VERT. 250# ASME
FLASH/INTERCOOLER/RECIRCULATION VESSEL
SCALE: 1/2" = 1'-0"

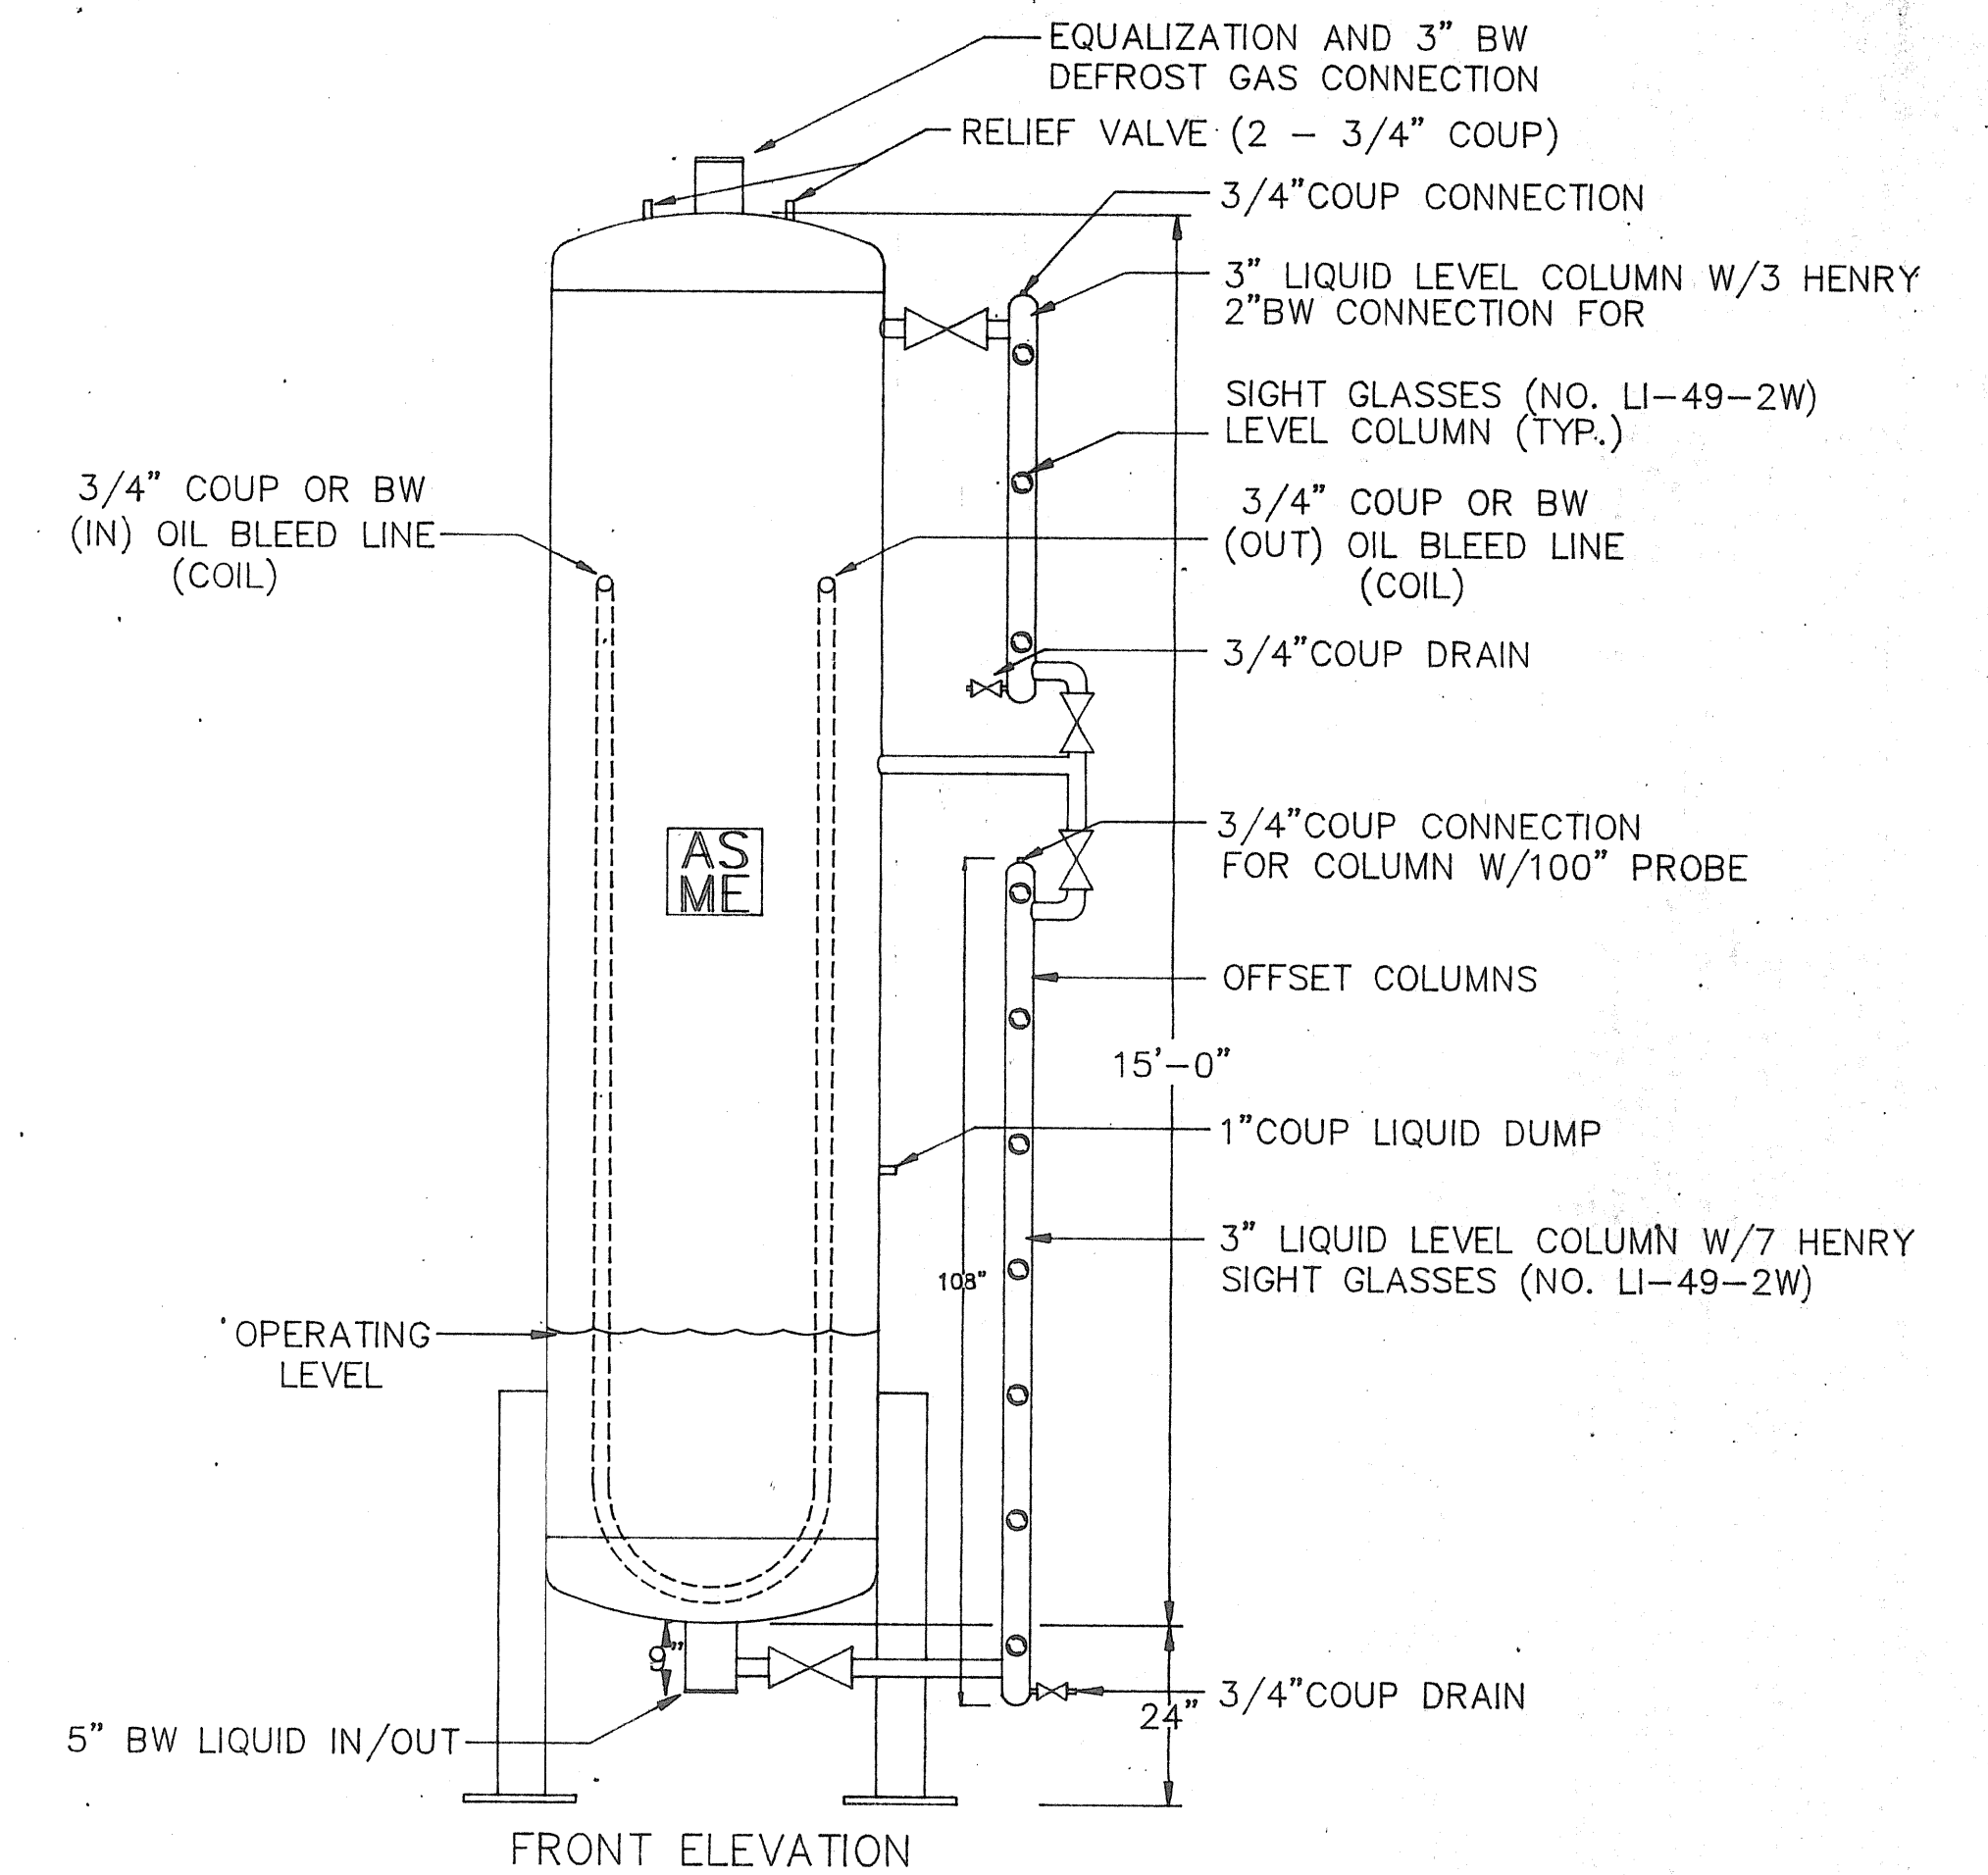

(+90) 42" O.D. X 15'-0" VERT 250# ASME
HIGH PRESSURE RECEIVER VESSEL
SCALE: 1/2" = 1'-0"

3. REV. ASBUILT	VR	9-15-94	J.P. KEMPF JR.
2. REV. VESS	VR	3-1-94	J.P. KEMPF JR.
NO.	REVISION	BY	DATE
J. P. KEMPF CO.			
REFRIGERATION CONTRACTORS			
87 CEDAR STREET,			
NORWALK, CT. 06854			
(203) 852-1920			
CUST.	PENNY CURTISS		
DESC.	PRESSURE VESSELS DETAIL		
PROJECT NO.	1260	ENG. BY	J.P. KEMPF
DATE	3-1-94	DWG. BY	V.F.R.
SCALE	1/2" = 1'-0"	DRAWING NO.	
FILE NAME	PEN-VES		

R-7

